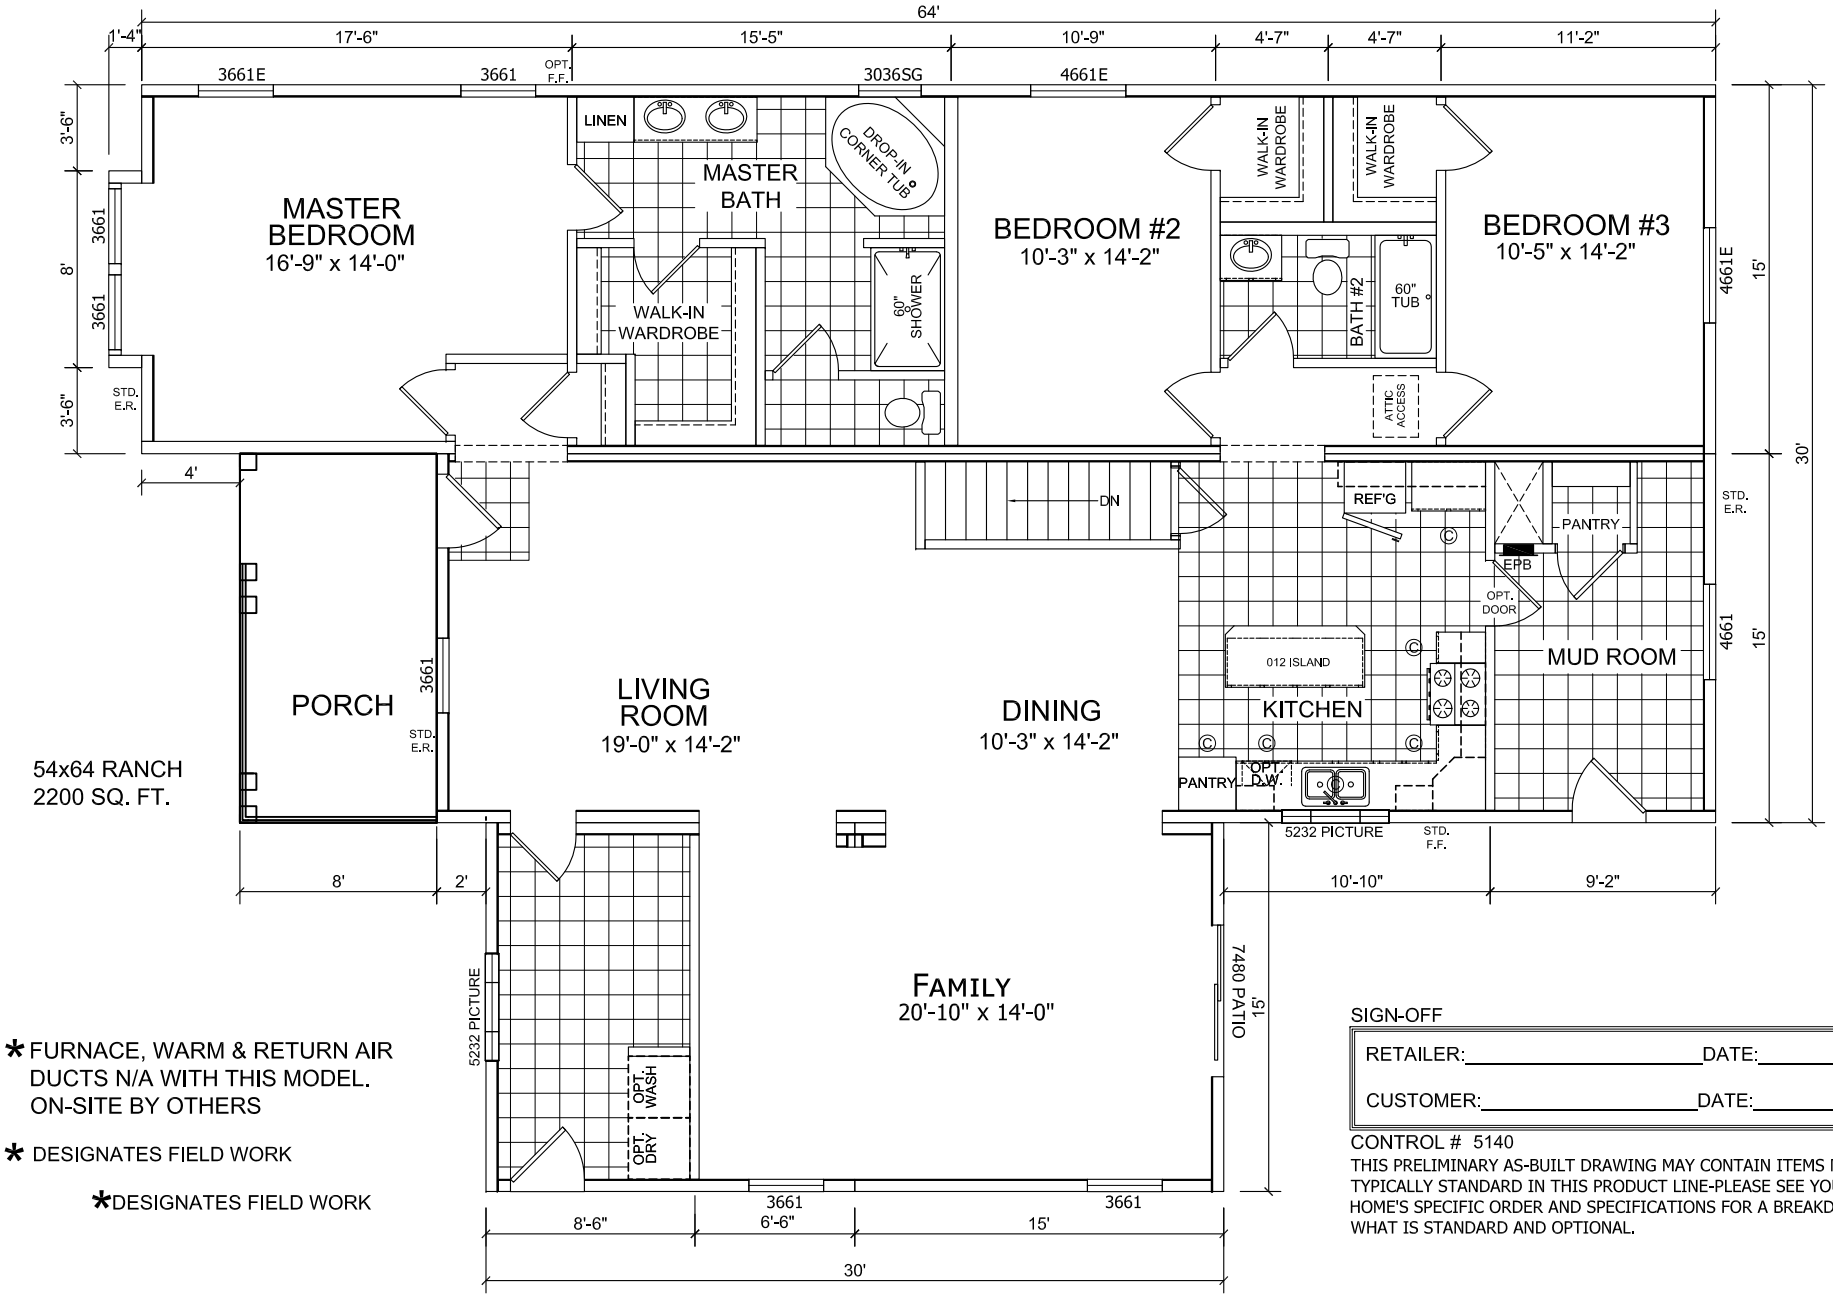

* FURNACE, WARM & RETURN AIR DUCTS N/A WITH THIS MODEL. ON-SITE BY OTHERS

* DESIGNATES FIELD WORK

*DESIGNATES FIELD WORK

SIGN-OFF

RETAILER:_____DATE:_____

CUSTOMER:_____DATE:_____

CONTROL # 5140

THIS PRELIMINARY AS-BUILT DRAWING MAY CONTAIN ITEMS NOT TYPICALLY STANDARD IN THIS PRODUCT LINE-PLEASE SEE YOUR HOME'S SPECIFIC ORDER AND SPECIFICATIONS FOR A BREAKDOWN OF WHAT IS STANDARD AND OPTIONAL.

CHAMPION

308 SHERIDAN DRIVE TOPEKA, IN 46571

APPROVER'S SEAL

MODIFICATIONS			
3	REMOVED MULL WINDOWS	---	08-13-14
4	MADE MASTER BEDROOM BUMPOUT LARGER	---	08-13-14
5	2015 UPDATES	---	11-03-14
6	ADDED STD. E.R	---	02-09-15

PROPRIETARY AND CONFIDENTIAL
THESE DRAWINGS AND SPECIFICATIONS ARE ORIGINAL, PROPRIETARY AND CONFIDENTIAL MATERIALS OF CHAMPION.
COPYRIGHT © 1976-2008 BY CHAMPION

MODEL: RM 1023-MI-02
3064 3BR 2BATH - RANCH

TITLE: LITERATURE PLAN

SHEET: L-101

DRAWN BY: T. COWLEY

DATE: 04-24-19

SCALE: 1/8" = 1'-0"